


AS-BUILT
 COMPILED FROM:
 FINAL PROOF SURVEY _____
 DATA FURNISHED BY CONTRACTOR X
 FIELD INSPECTION RECORDS X
WESTECH ENGINEERING, INC.
 DATE: SEPT. 04 BY: MDP

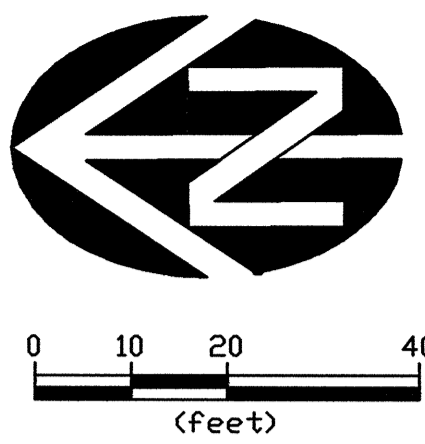


NO.	DATE	DESCRIPTION	BY
1	9/29/03	AGENCY REVIEW SET	RCE
2	9/29/03	BID SET	RCE
3	1/6/03	BROADWAY ALIGNMENT CHANGE	RCE

VERIFY SCALE
 BAR IS ONE INCH ON ORIGINAL DRAWING
 IF NOT ONE INCH ON THIS SCALE ACCORDINGLY

DATE/MAR. 2003

AS-CONSTRUCTED
 REGISTERED PROFESSIONAL ENGINEER
 19178PE
 OREGON
 W. F. MOYD C.
 CERT. EXP. DECEMBER 31, 2003

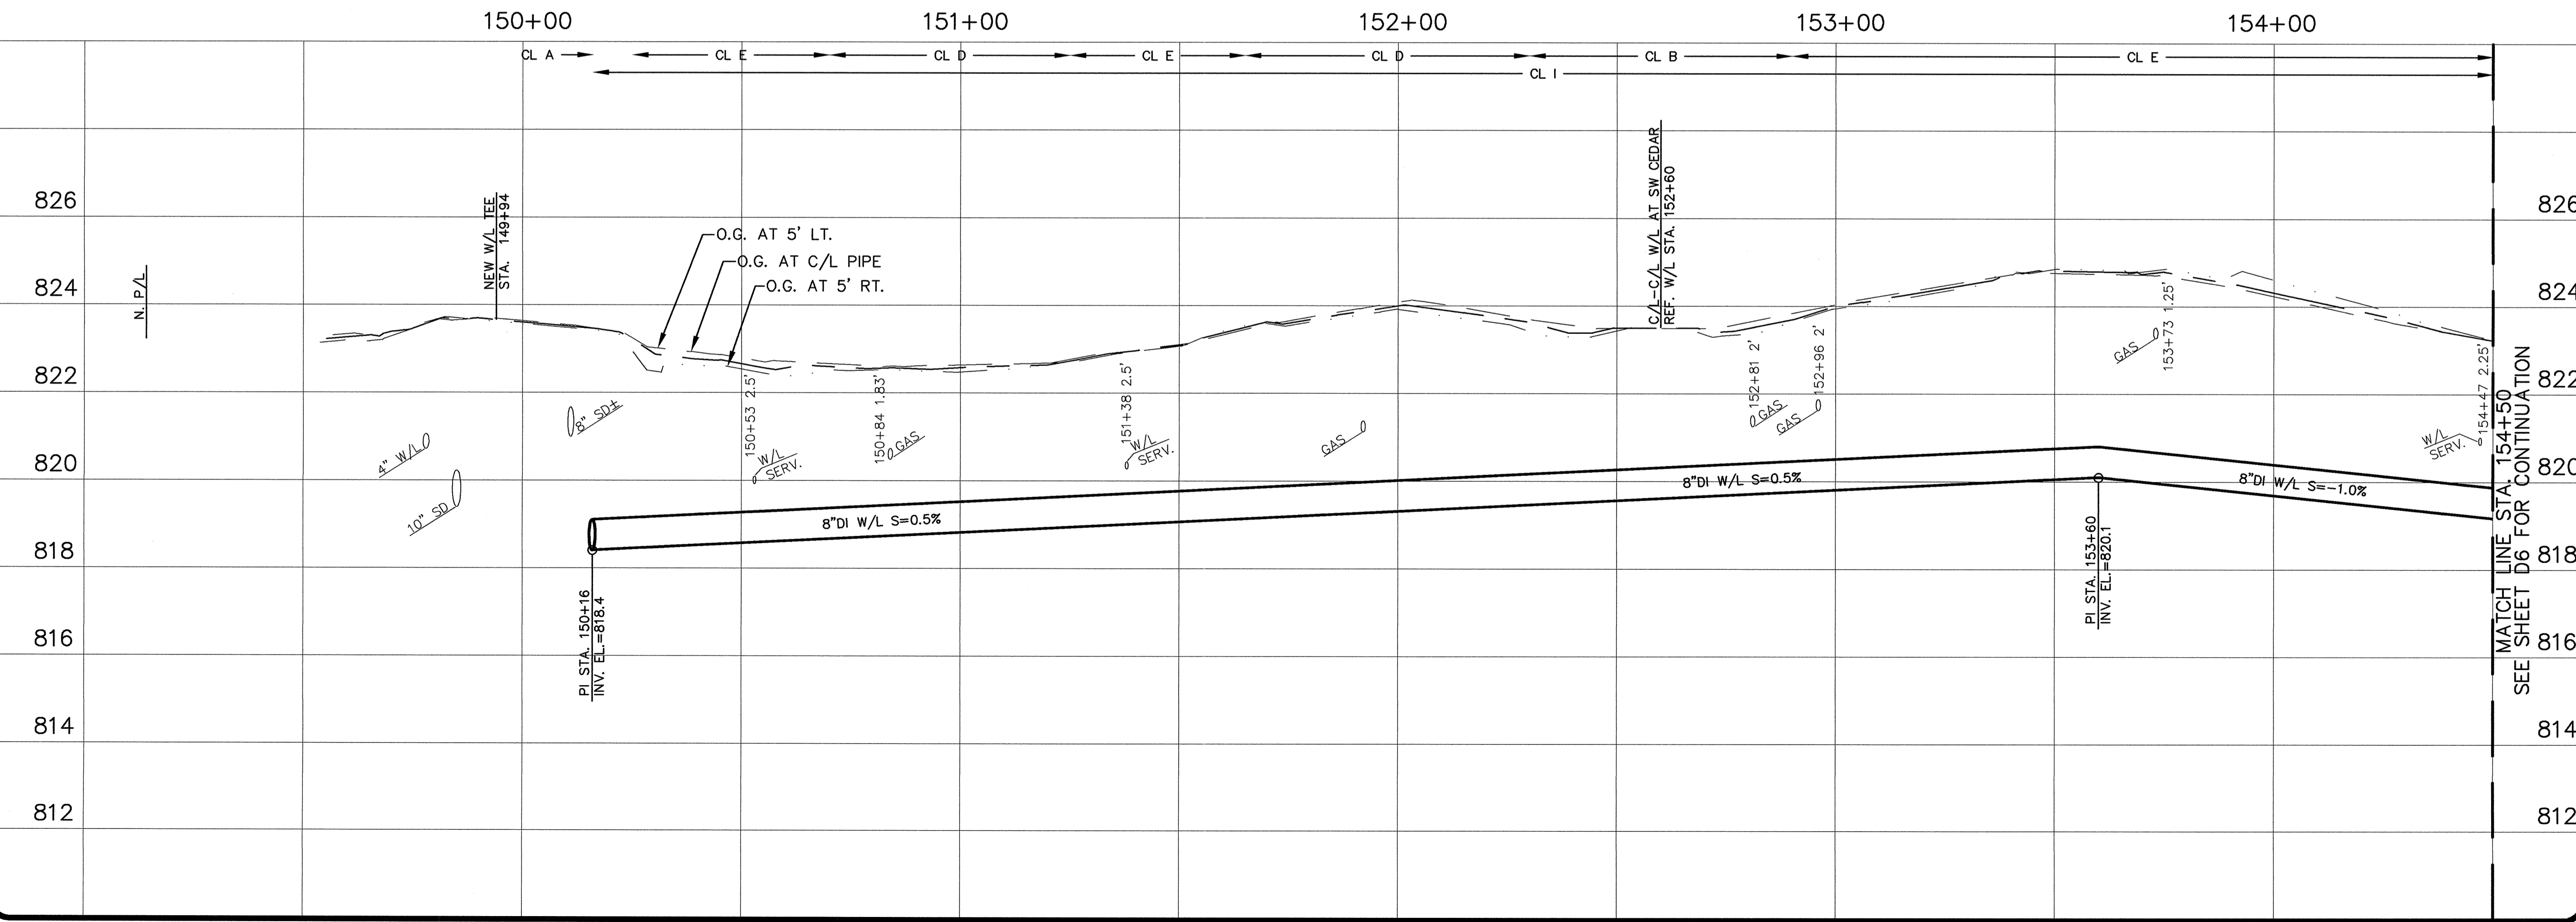




WESTECH ENGINEERING, INC.
 CONSULTING ENGINEERS AND PLANNERS

3841 Fairview Industrial Dr. S.E., Suite 100, Salem, OR 97302
 Phone: (503) 585-2474 Fax: (503) 585-3986
 E-mail: westech@westech-eng.com

CITY OF MILL CITY, OREGON
 MILL CITY WATER IMP. PROJECT-WATERLINES
SW 5TH AVE.
PLAN AND PROFILE
 STA. 149+50 TO STA. 154+50


SHEET
 D5 OF 15
JOB NUMBER
 1780.4060.0

Doc: 28_2004 - 9:44am
 R:\Draws\Mill City\Water Project\Waterlines\CIVIL\PLOTS\SW-3RD-01.dwg (LAYOUT Tab)

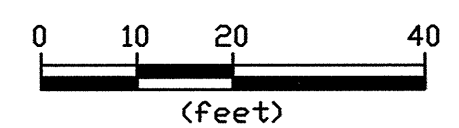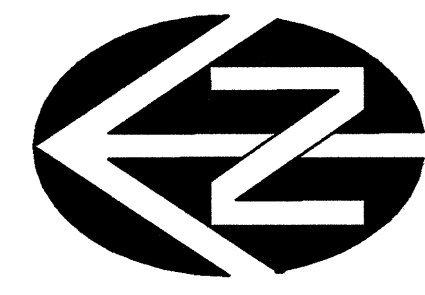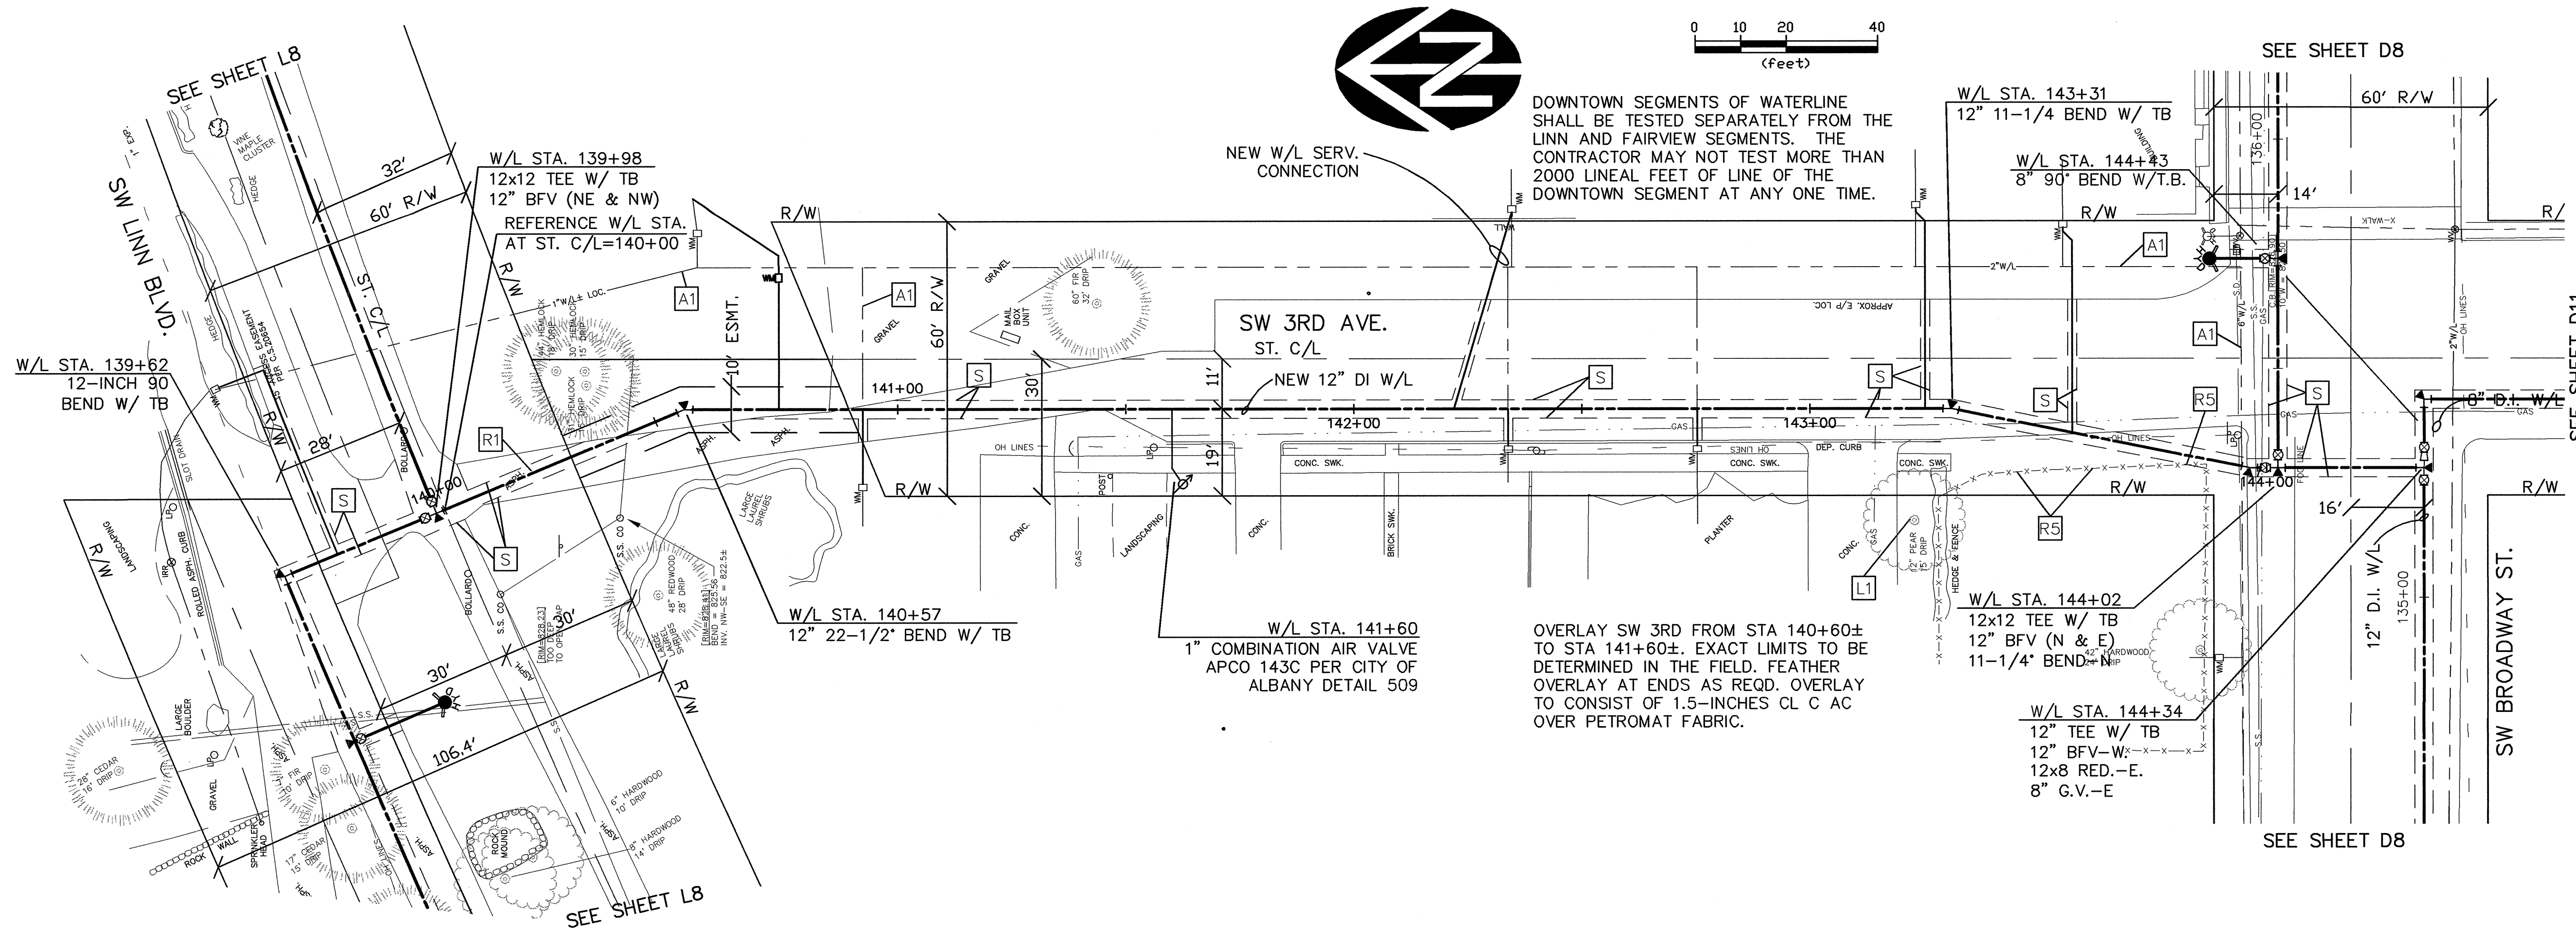

DOWNTOWN SEGMENTS OF WATERLINE SHALL BE TESTED SEPARATELY FROM THE LINN AND FAIRVIEW SEGMENTS. THE CONTRACTOR MAY NOT TEST MORE THAN 2000 LINEAL FEET OF LINE OF THE DOWNTOWN SEGMENT AT ANY ONE TIME.

OVERLAY SW 3RD FROM STA 140+60± TO STA 141+60±. EXACT LIMITS TO BE DETERMINED IN THE FIELD. FEATHER OVERLAY AT ENDS AS REQD. OVERLAY TO CONSIST OF 1.5-INCHES CL C AC OVER PETROMAT FABRIC.

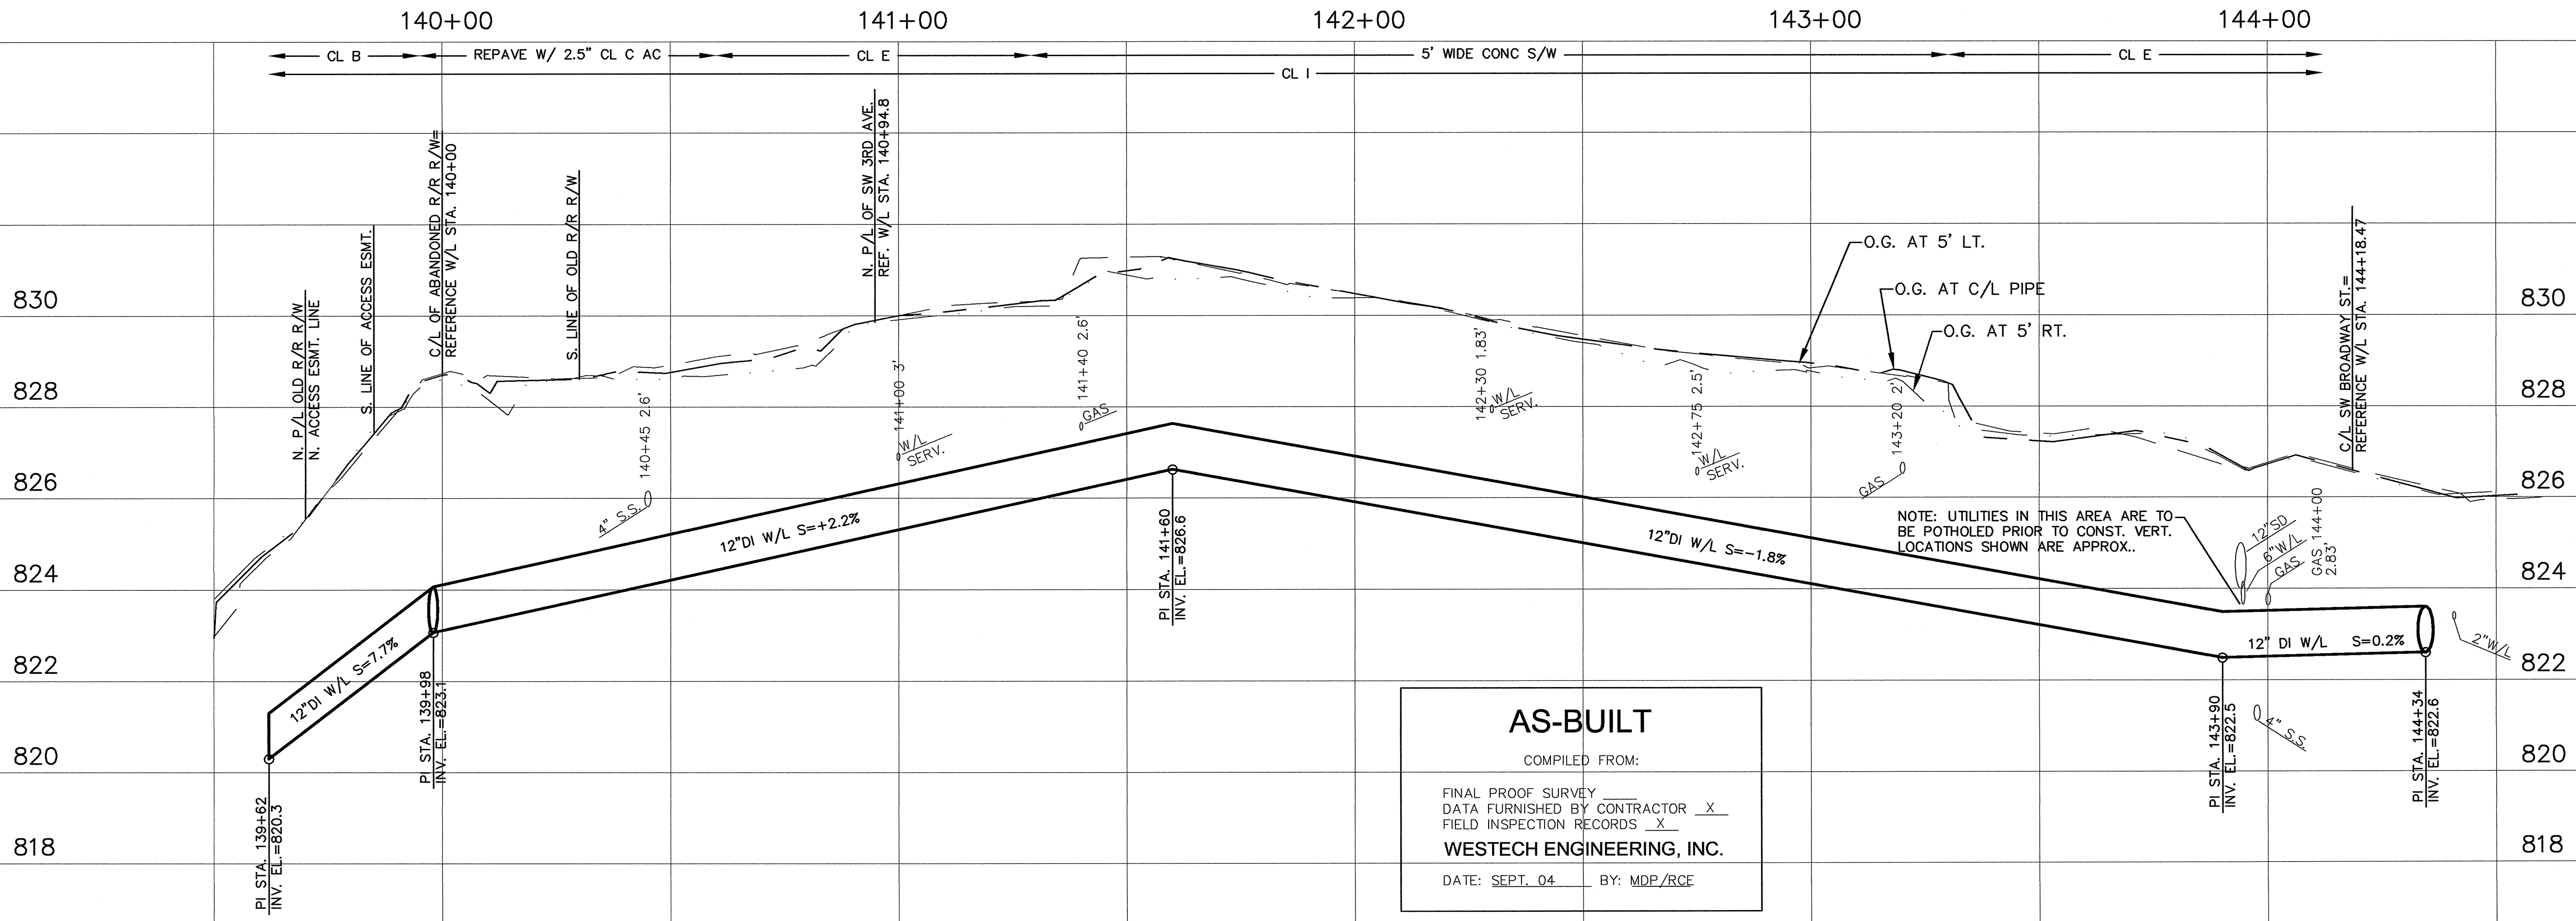

AS-BUILT
 COMPILED FROM:
 FINAL PROOF SURVEY _____
 DATA FURNISHED BY CONTRACTOR X
 FIELD INSPECTION RECORDS X
WESTTECH ENGINEERING, INC.
 DATE: SEPT. 04 BY: MDP/RCE

NO.	DATE	DESCRIPTION	BY
1	5/20/03	AGENCY REVIEW SET	RCE
2	6/7/03	BID SET	RCE
3	11/7/03	BROADWAY ALIGNMENT CHANGE	RCE

VERIFY SCALE
 BAR IS ONE INCH ON ORIGINAL DRAWING
 IF NOT ONE INCH ON SCALES ACCORDINGLY




AS-CONSTRUCTED
 WESTTECH ENGINEERING, INC.
 3941 Fairview Industrial Dr. S.E., Suite 100, Salem, OR 97302
 Phone: (503) 585-2474 Fax: (503) 585-3986
 E-mail: westtech@westtech-eng.com

WESTTECH ENGINEERING, INC.
 CONSULTING ENGINEERS AND PLANNERS

CITY OF MILL CITY, OREGON
 MILL CITY WATER IMP. PROJECT - WATERLINES
 SW 3RD AVE.
 PLAN AND PROFILE
 STA. 139+50 TO END

CITY OF MILL CITY, OREGON
 MILL CITY WATER IMP. PROJECT - WATERLINES
 SW 3RD AVE.
 PLAN AND PROFILE
 STA. 139+50 TO END

SHEET
 D10 OF 15
 JOB NUMBER
 1780.4060.0

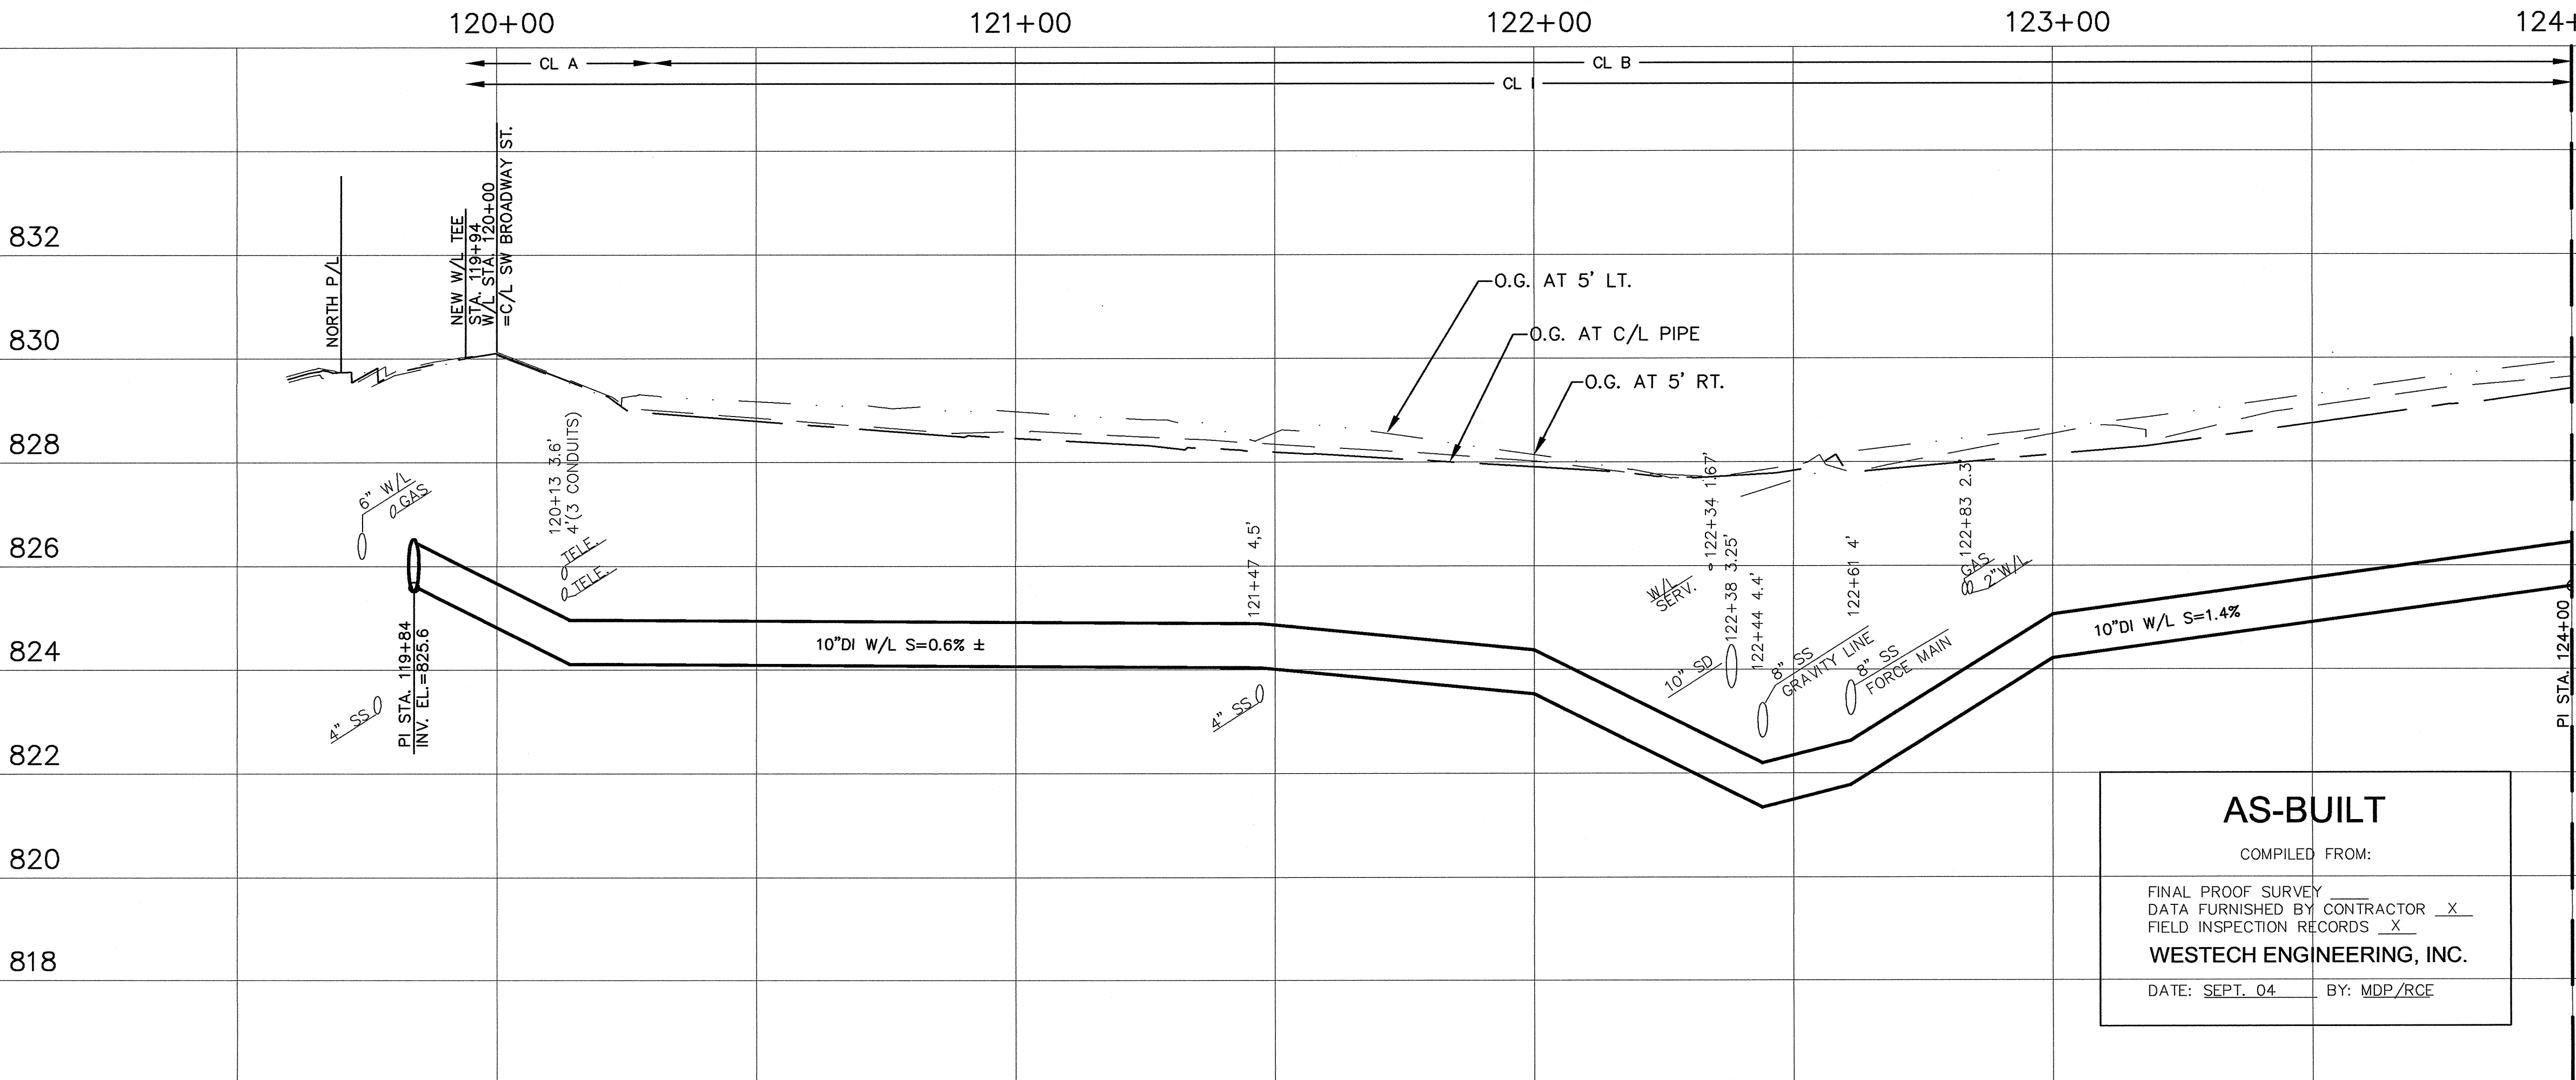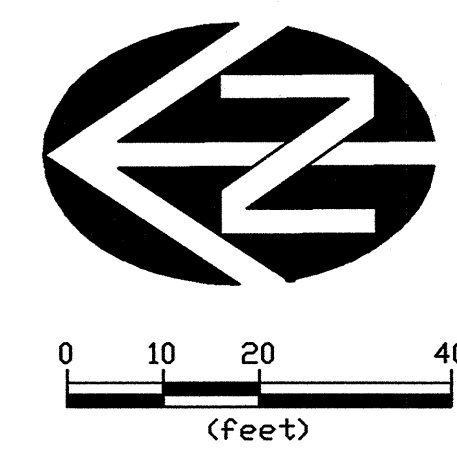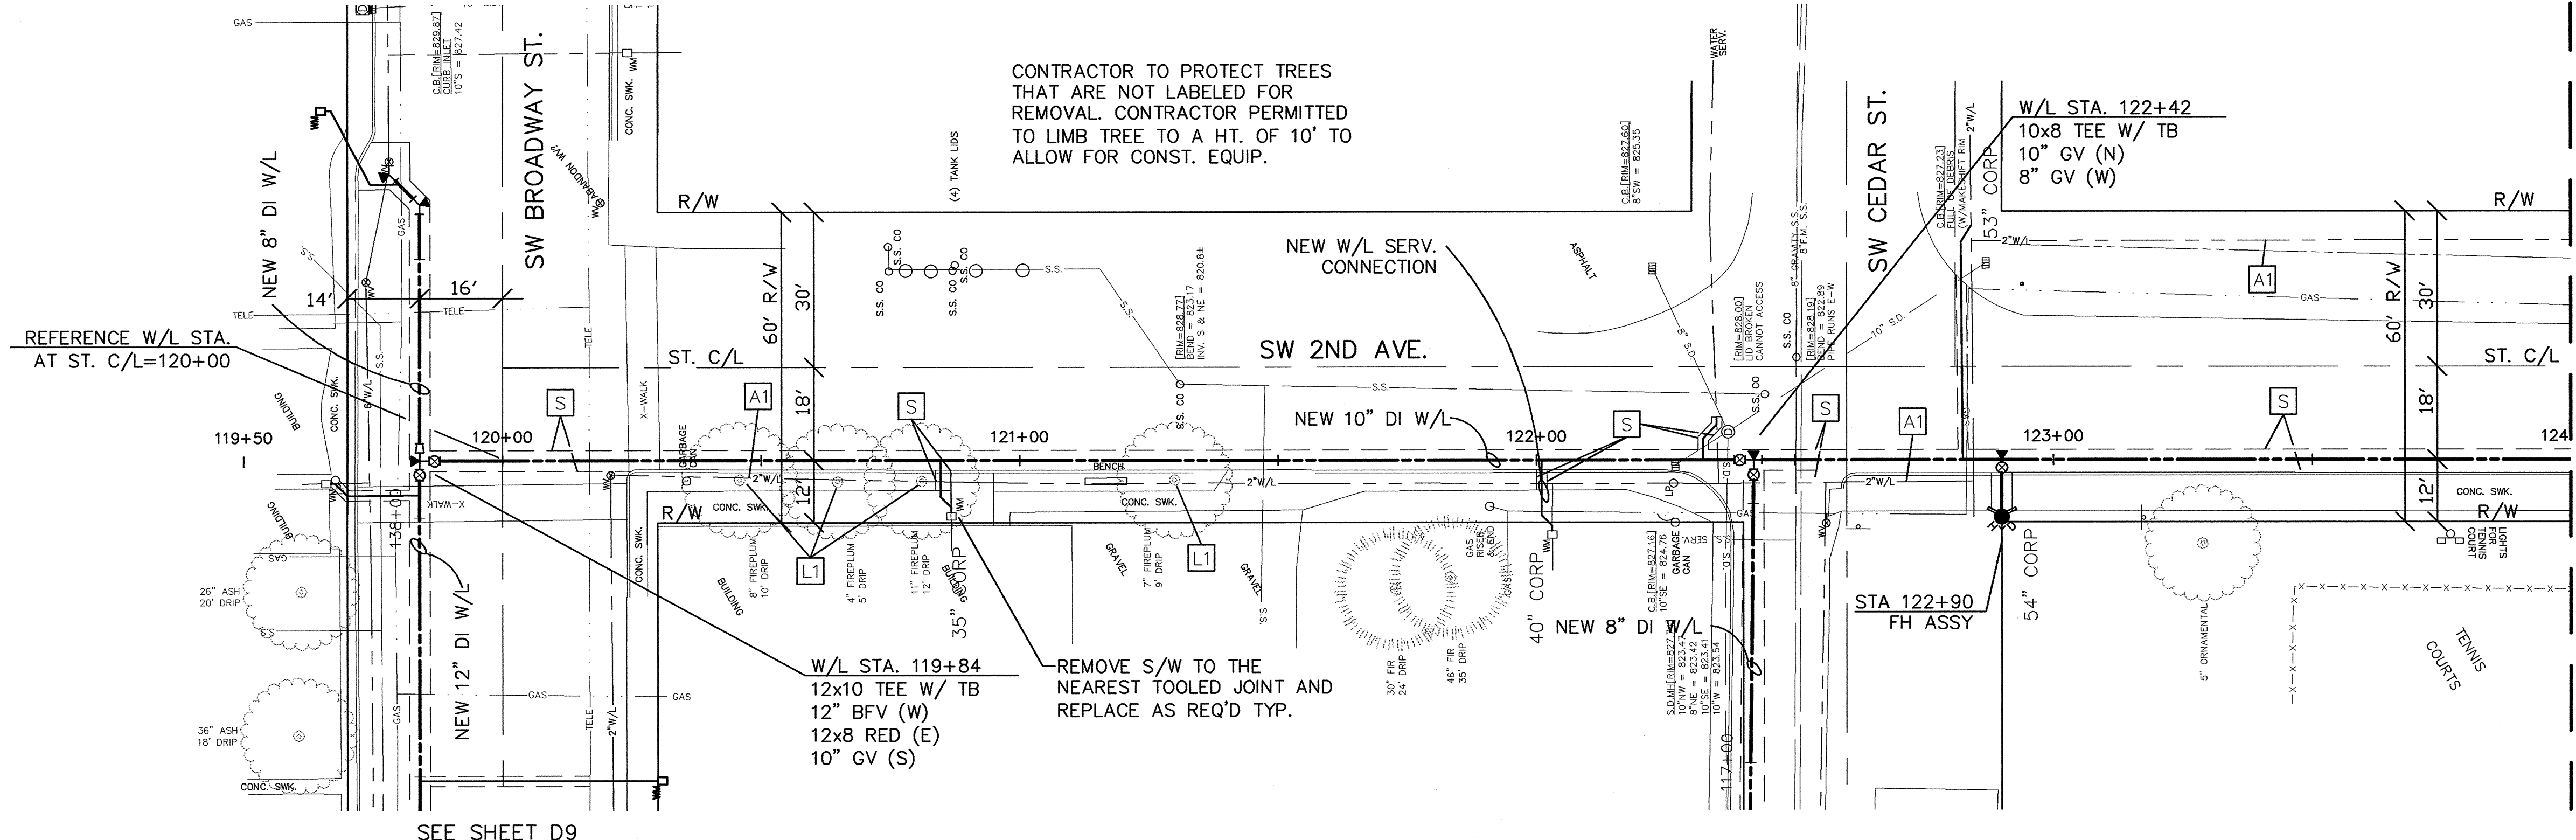

VERIFY SCALE	NO.	DATE	DESCRIPTION	BY
BAR IS ONE INCH ON ORIGINAL DRAWING	1	5/20/03	AGENCY REVIEW SET	RCE
IF NOT ONE INCH ON SCALES ACCORDINGLY	2	6/26/03	BID SET	RCE
	3	11/26/03	BROADWAY ALIGNMENT CHANGE	RCE
	4	11/26/03	BROADWAY ALIGNMENT CHANGE	RCE
	5	11/26/03	BROADWAY ALIGNMENT CHANGE	RCE
CITY OF MILL CITY, OREGON
 MILL CITY WATER IMP. PROJECT-WATERLINES
 SW 2ND AVE.
 PLAN AND PROFILE
 STA. 119+50 TO STA. 124+00

WESTECH ENGINEERING, INC.
 CONSULTING ENGINEERS AND PLANNERS
 3841 Fairview Industrial Dr., Suite 100, Salem, OR 97302
 Phone: (503) 585-2474 Fax: (503) 585-3886
 E-mail: westech@westech-eng.com

REGISTERED PROFESSIONAL ENGINEER
 191789F
 OREGON
 JUL 15, 2003
 P. A. MOUND C.
 CERT. EXP. DECEMBER 31, 2003

AS-CONSTRUCTED

SHEET
 D13 OF 15
 JOB NUMBER
 1780.4060.0



AS-BUILT

COMPILED FROM:

FINAL PROOF SURVEY _____
 DATA FURNISHED BY CONTRACTOR X
 FIELD INSPECTION RECORDS X

WESTECH ENGINEERING, INC.


DATE: SEPT. 04 BY: MDP/RCE

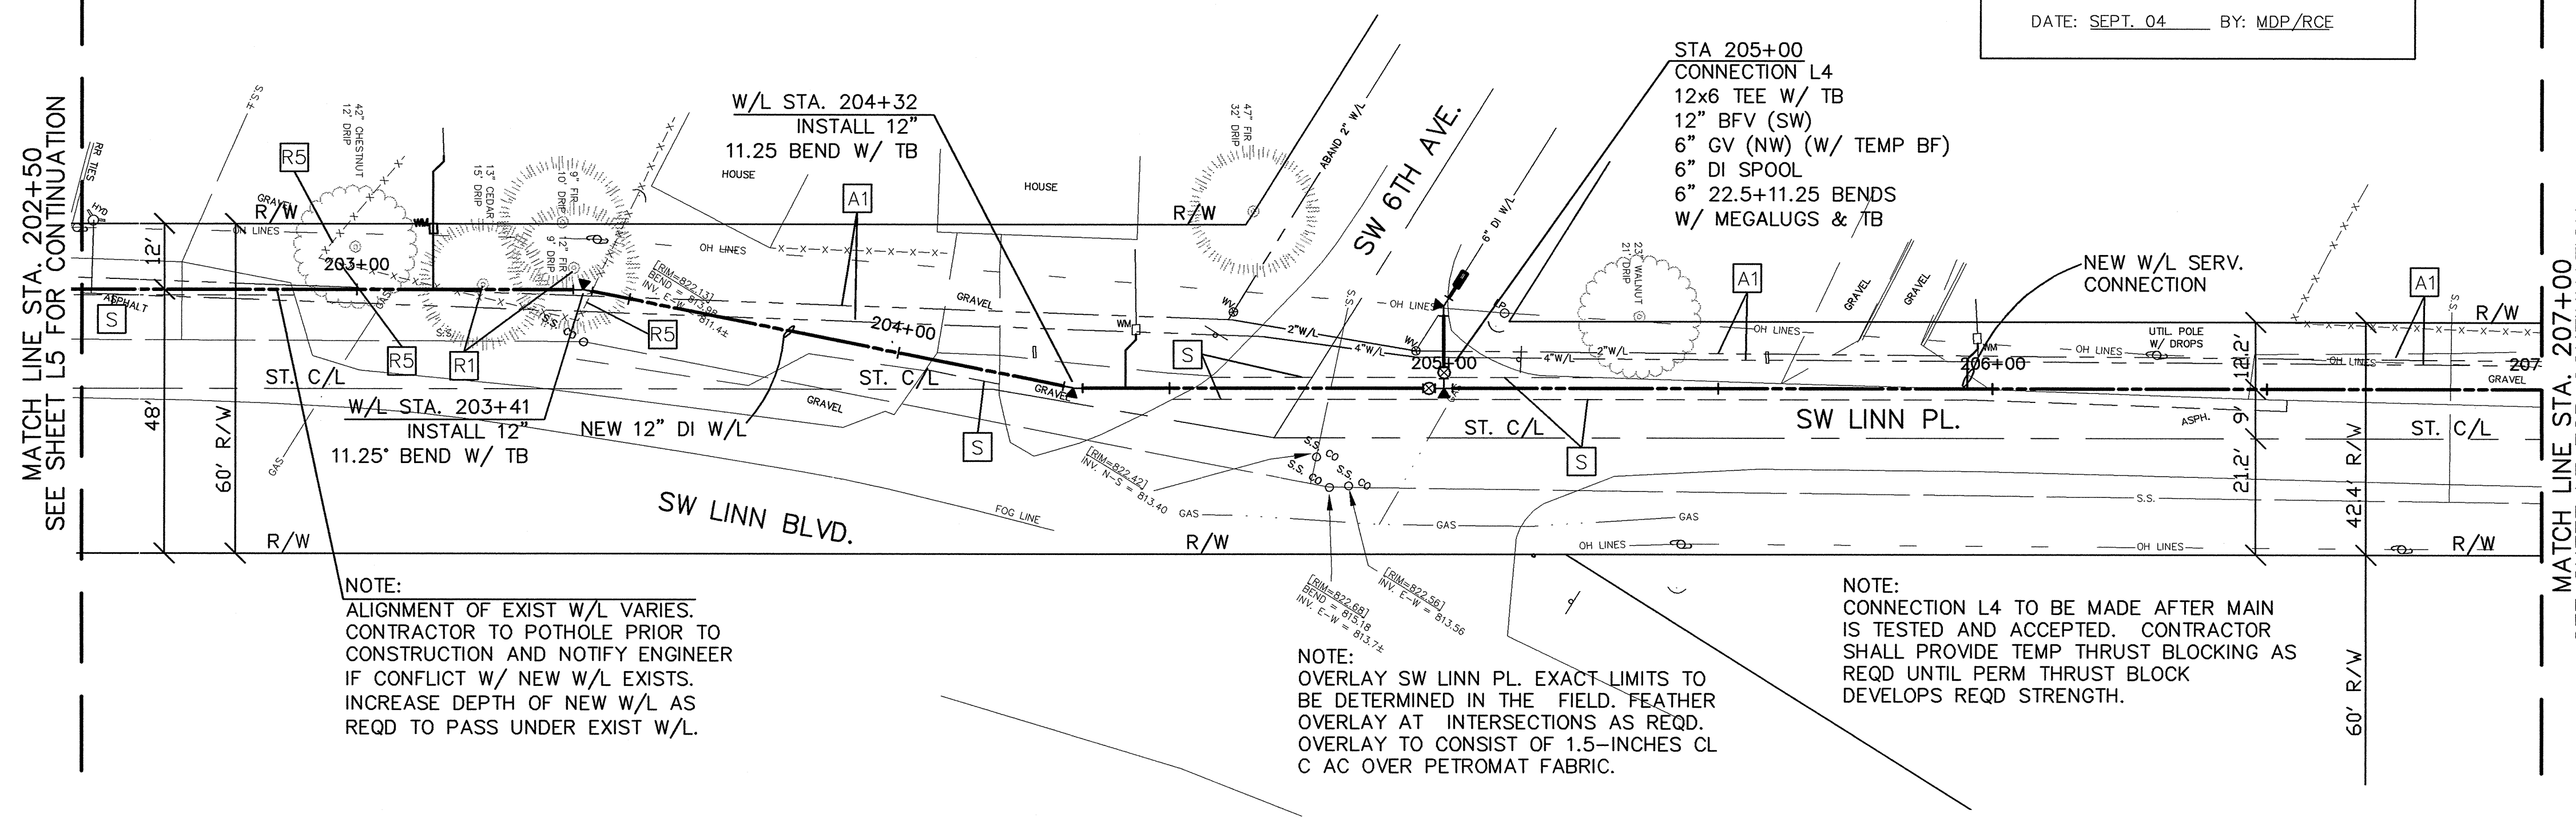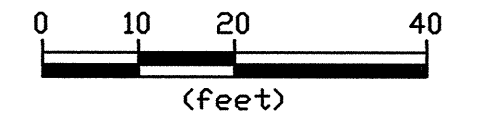

NOTE:
 ALIGNMENT OF EXIST W/L VARIES.
 CONTRACTOR TO POTHOLE PRIOR TO
 CONSTRUCTION AND NOTIFY ENGINEER
 IF CONFLICT W/ NEW W/L EXISTS.
 INCREASE DEPTH OF NEW W/L AS
 REQD TO PASS UNDER EXIST W/L.

NOTE:
 OVERLAY SW LINN PL. EXACT LIMITS TO
 BE DETERMINED IN THE FIELD. FEATHER
 OVERLAY AT INTERSECTIONS AS REQD.
 OVERLAY TO CONSIST OF 1.5-INCHES CL
 C AC OVER PETROMAT FABRIC.

NOTE:
 CONNECTION L4 TO BE MADE AFTER MAIN
 IS TESTED AND ACCEPTED. CONTRACTOR
 SHALL PROVIDE TEMP THRUST BLOCKING AS
 REQD UNTIL PERM THRUST BLOCK
 DEVELOPS REQD STRENGTH.

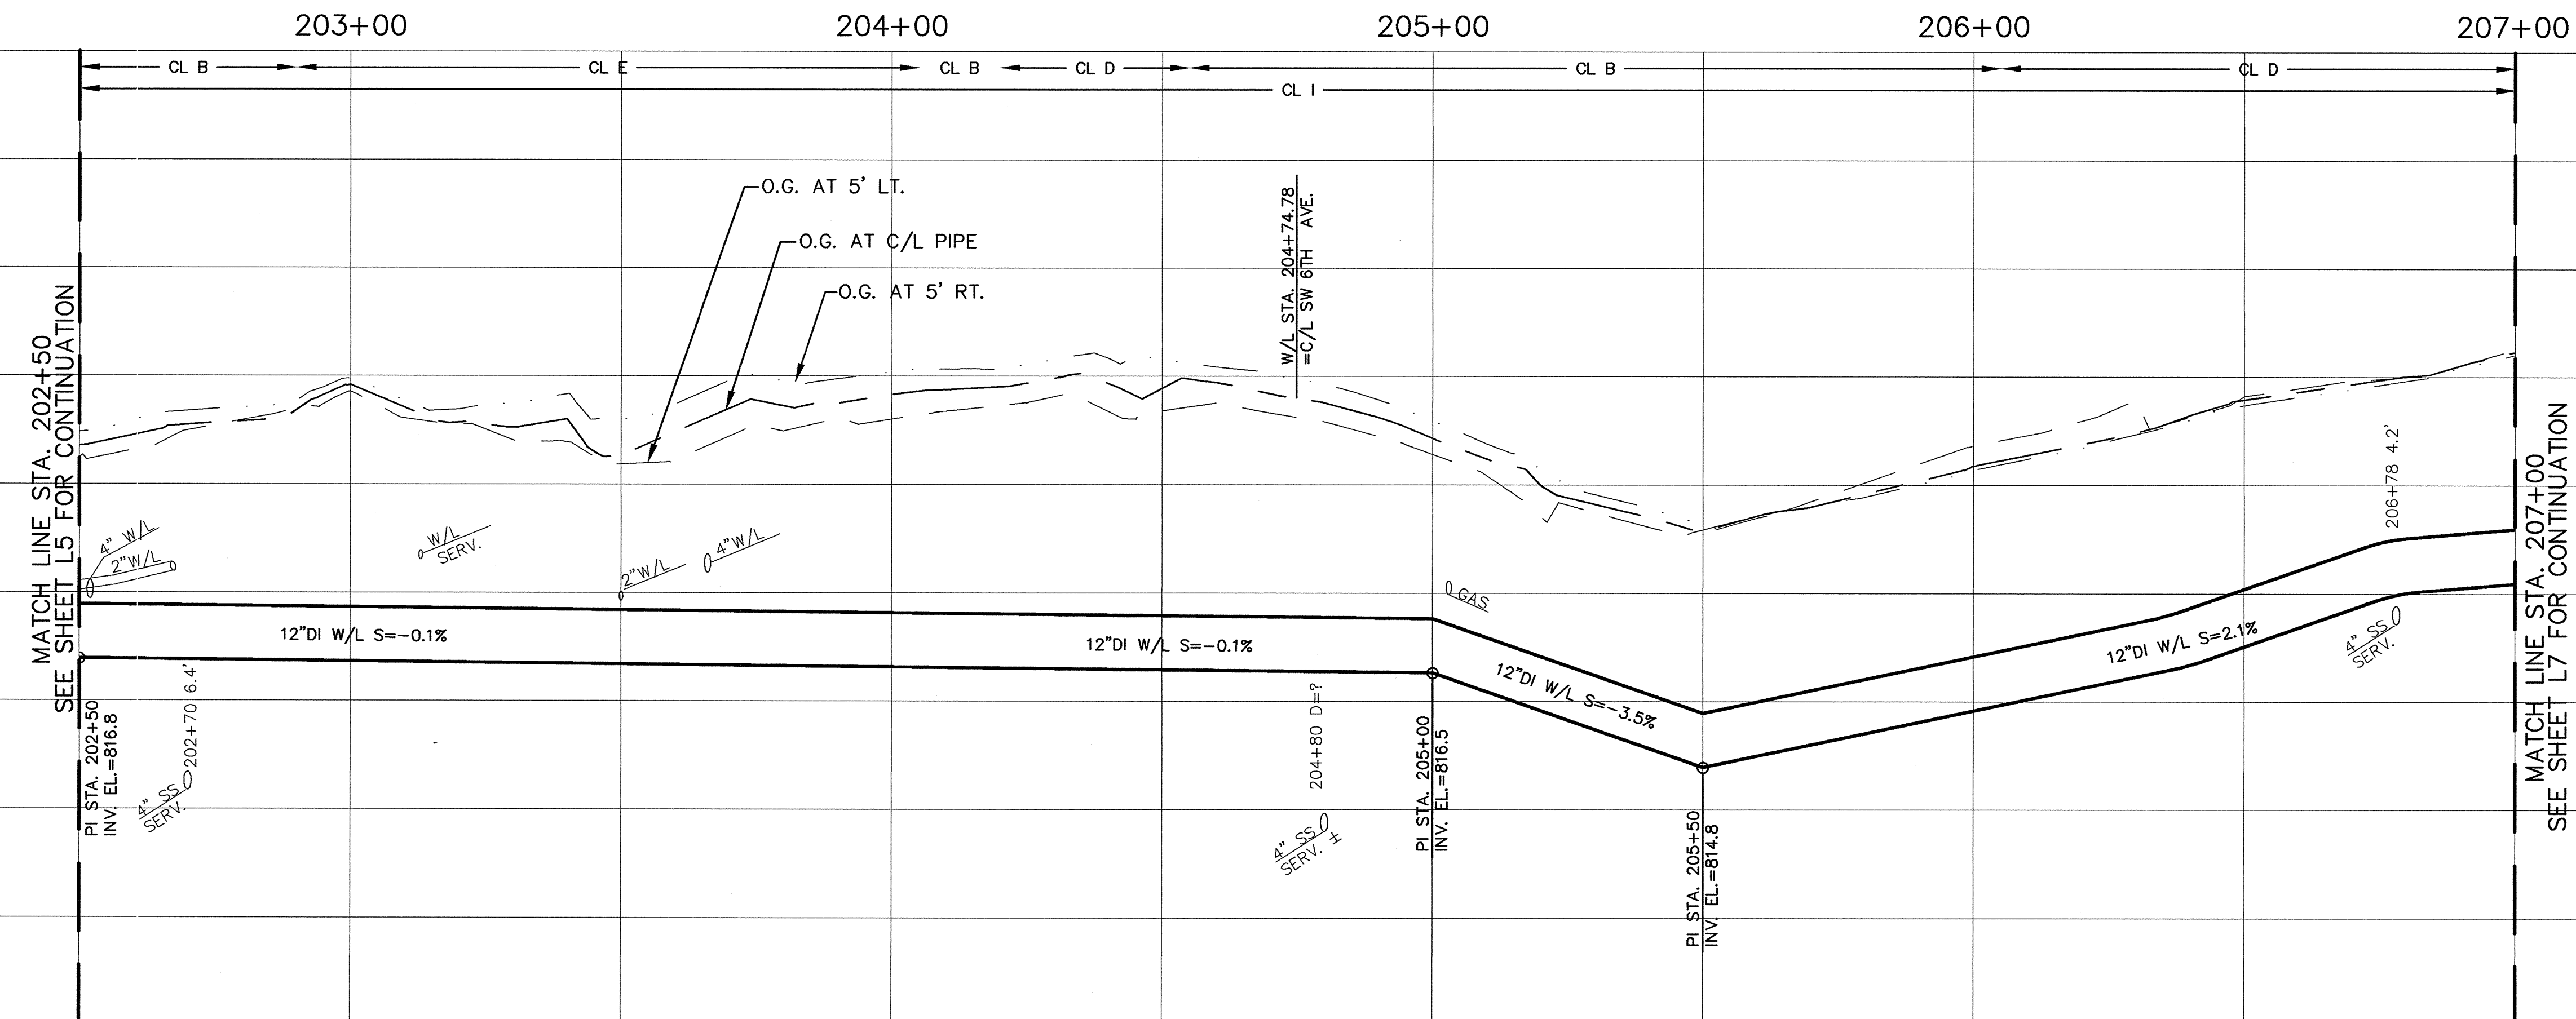


MATCH LINE STA. 202+50
 SEE SHEET L5 FOR CONTINUATION

MATCH LINE STA. 207+00
 SEE SHEET L7 FOR CONTINUATION

NO.	DATE	DESCRIPTION	BY
1	5/29/03	AGENCY REVIEW SET	RCE
2	6/2/03	BID SET	RCE

VERIFY SCALE
 BAR IS ONE INCH ON
 ORIGINAL DRAWING
 1" = 40'

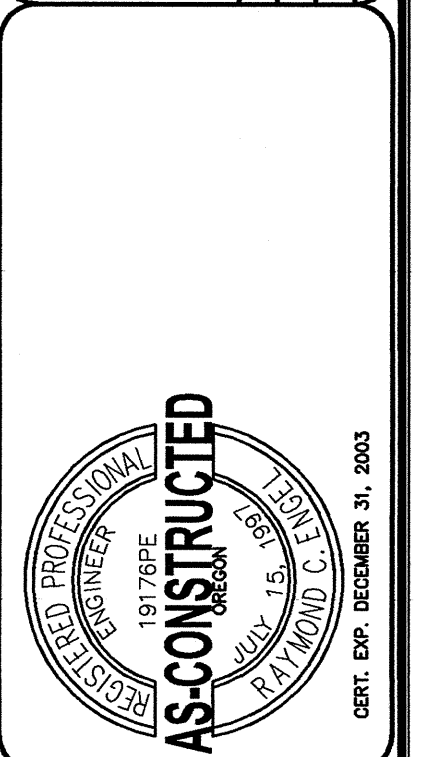

WESTECH ENGINEERING, INC.
 CONSULTING ENGINEERS AND PLANNERS
AS-CONSTRUCTED
 3841 Fairview Industrial Dr. S.E., Suite 100, Salem, OR 97302
 Phone: (503) 585-2474 Fax: (503) 585-3986
 E-mail: westech@westech-eng.com

CITY OF MILL CITY, OREGON
 MILL CITY WATER IMP. PROJECT-WATERLINES
 SW LINN BLVD.
 PLAN AND PROFILE
 STA. 202+50 TO STA. 207+00

SHEET
 L6 OF 10
 JOB NUMBER
 1780.4060.0

